

**CHANGE ORDER NO.: 1.5**

Owner:	City of Clinton	Owner's Project No.:	
Engineer:		Engineer's Project No.:	
Contractor:	Superior Services & Supply, LLC	Contractor's Project No.:	51-22-1439
Project:	GST Roof Replacement and Coatings Rehabilitation		
Contract Name:			
Date Issued:	10/7/2024	Effective Date of Change Order:	10/7/2024

The Contract is modified as follows upon execution of this Change Order:

Description: ~~Supply logo stencil and paint and apply slightly smaller logo~~  
 •Blast clean and welding to repair leak at base of weir box  
 •Repair few small leaks at top and bottom of external overflow pipe  
 •Install interior ladder for diver entry

Change in Contract Price	Change in Contract Times [State Contract Times as either a specific date or a number of days]
Original Contract Price: \$ 1,769,542.35	Original Contract Times: Substantial Completion: N/A Ready for final payment: N/A
[Increase] [Decrease] from previously approved Change Orders No. 1 to No. [Number of previous Change Order]: \$ N/A	[Increase] [Decrease] from previously approved Change Orders No.1 to No. [Number of previous Change Order]: Substantial Completion: N/A Ready for final payment: N/A
Contract Price prior to this Change Order: \$ 1,769,542.35	Contract Times prior to this Change Order: Substantial Completion: N/A Ready for final payment: N/A
<del>(Increase)</del> [Decrease] this Change Order: \$ 14,150.00	[Increase] [Decrease] this Change Order: Substantial Completion: N/A Ready for final payment: N/A
Contract Price incorporating this Change Order: \$ 1,783,692.35	Contract Times with all approved Change Orders: Substantial Completion: N/A Ready for final payment: N/A

Recommended by Engineer (if required)

By: \_\_\_\_\_  
 Title: \_\_\_\_\_  
 Date: \_\_\_\_\_

Accepted by Contractor

Superior Services & Supply, LLC  
  
 Project Manager  
 10/7/2024

Authorized by Owner

By: \_\_\_\_\_  
 Title: \_\_\_\_\_  
 Date: \_\_\_\_\_

Approved by Funding Agency (if applicable)

By: \_\_\_\_\_  
 Title: \_\_\_\_\_  
 Date: \_\_\_\_\_

**Robert Johnston**

---

**From:** Gene McCullough  
**Sent:** Tuesday, October 1, 2024 9:20 AM  
**To:** Robert Johnston; Amy Jones  
**Subject:** Fw: Change order request 1 - Clinton OK - Misc repairs and logo

Thanks,

gene

---

**From:** Jamie Stewart <jstewart@superior-svc.com>  
**Sent:** Tuesday, October 1, 2024 9:02:52 AM  
**To:** Gene McCullough <Gene.McCullough@clintonok.gov>  
**Subject:** RE: Change order request 1 - Clinton OK - Misc repairs and logo

Gene ,

Here is the break down of the cost

Miscellaneous repairs with Logo rendering by Lake Area Signs ----- \$30,150

- Supply logo stencil and paint and apply slightly smaller logo .....\$16,000
- Blast clean and welding to repair leak at base of weir box ..... \$3,250
- Repair few small leaks at top and bottom of external overflow pipe. .... \$3,250
- Install interior ladder and platform for diver entry\* ..... \$6,000
- Ladder (8-10 ft) .....\$1,650

---

**From:** Gene McCullough <Gene.McCullough@clintonok.gov>  
**Sent:** Tuesday, October 1, 2024 8:37 AM  
**To:** Jamie Stewart <jstewart@superior-svc.com>  
**Subject:** RE: Change order request 1 - Clinton OK - Misc repairs and logo

**Caution:** This email originates from outside the organization.  
Do not click links or open attachments unless you recognize the sender and know the content is safe.


---

Can you get that today? Might be able to do it under new business

---

**From:** Jamie Stewart <jstewart@superior-svc.com>  
**Sent:** Monday, September 30, 2024 10:26 AM  
**To:** Gene McCullough <Gene.McCullough@clintonok.gov>  
**Subject:** RE: Change order request 1 - Clinton OK - Misc repairs and logo

Ill get the break down sent soon. When is the board meeting?

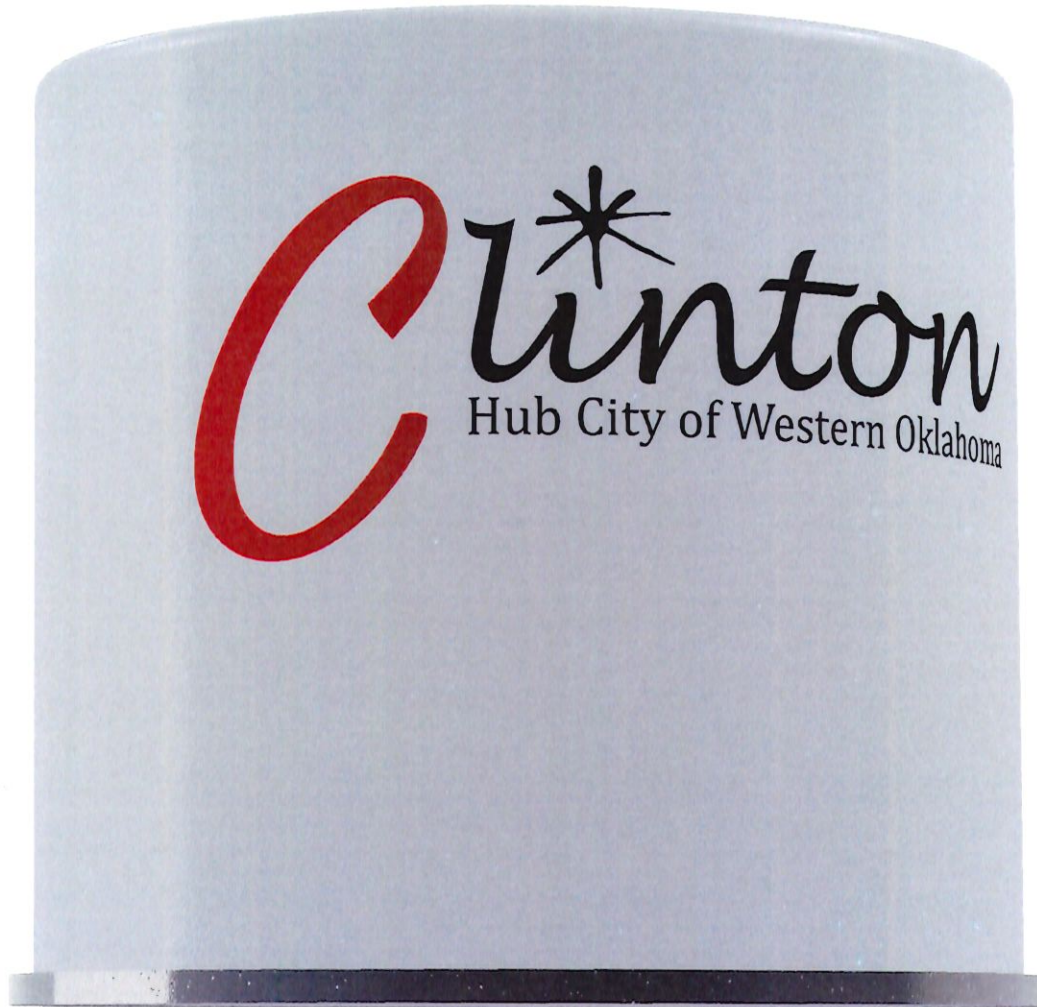

Logo Length: 75'-0"  
 Logo Height: 29'-9"

ARK PRINTS LLC

Hugo Bocanegra  
 501-305-9998

Client: LCC  
 Project: Clinton, OK

Signature: \_\_\_\_\_

Date: \_\_\_\_\_

Aproved     Aproved as Noted  
 Resubmit

**NOTICE**

1. Verify tank dimensions. Dimensions can vary depending on tank manufacturer.
2. Orentation should be determiend by Owner Engineer and Contractor.
3. 3D model color display is an approximation and should only be use as a visual aid

Project: Clinton, OK


Drawn: Hugo Bocanegra

Date: 9/18/2024

REV:

Scale: Scale

Sheet: SHEET 2 OF 2

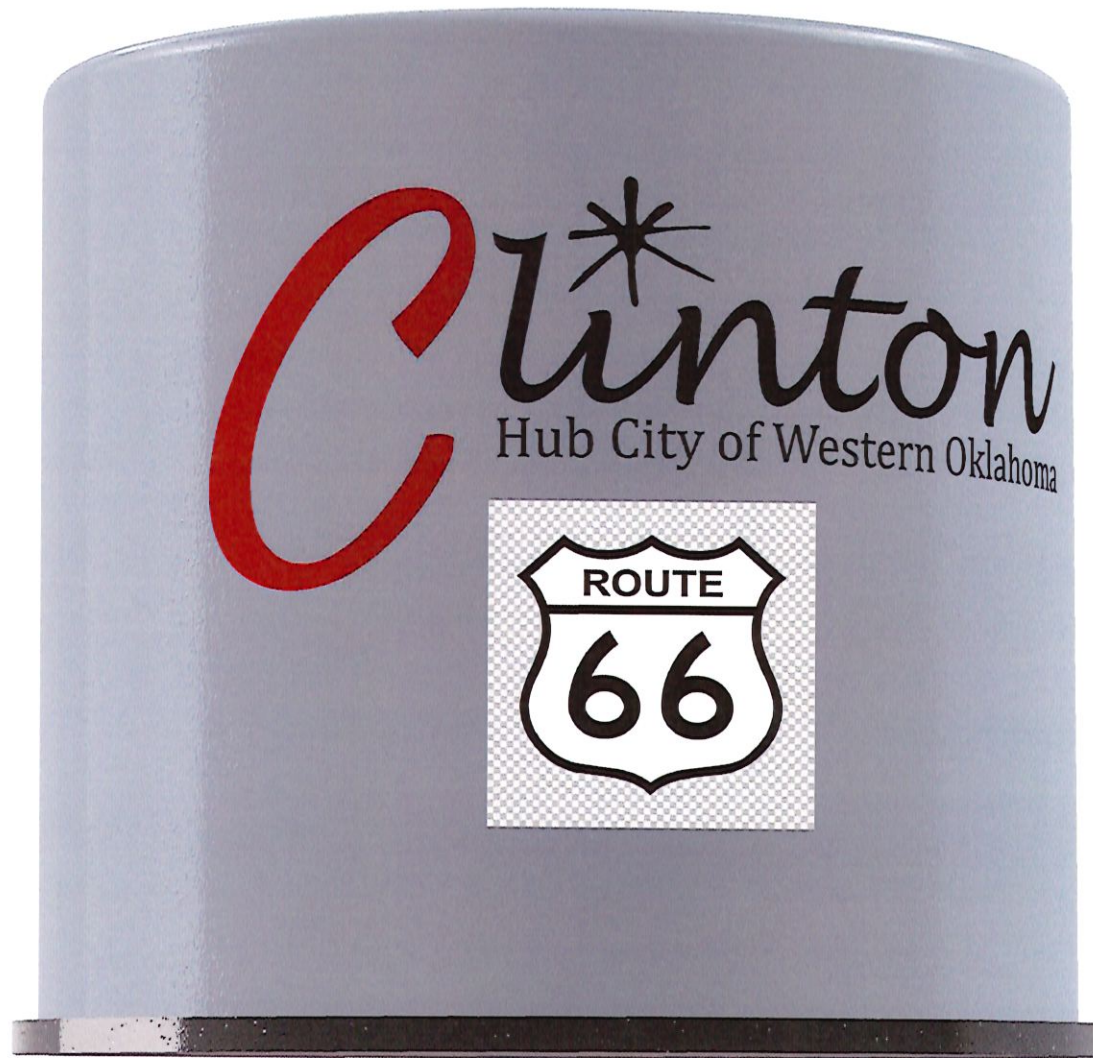

Logo Length: 75'-0"  
 Logo Height: 29'-9"

ARK PRINTS LLC

Hugo Bocanegra  
 501-305-9998

Client: LCC  
 Project: Clinton, OK

Signature: \_\_\_\_\_

Date: \_\_\_\_\_

Aproved     Aproved as Noted  
 Resubmit

**NOTICE**

1. Verify tank dimensions. Dimensions can vary depending on tank manufacturer.
2. Orentation should be determiend by Owner Engineer and Contractor.
3. 3D model color display is an approximation and should only be use as a visual aid

Project: Clinton, OK

Drawn: Hugo Bocanegra

Date: 9/18/2024

REV:

Scale: Scale

Sheet: SHEET 2 OF 2